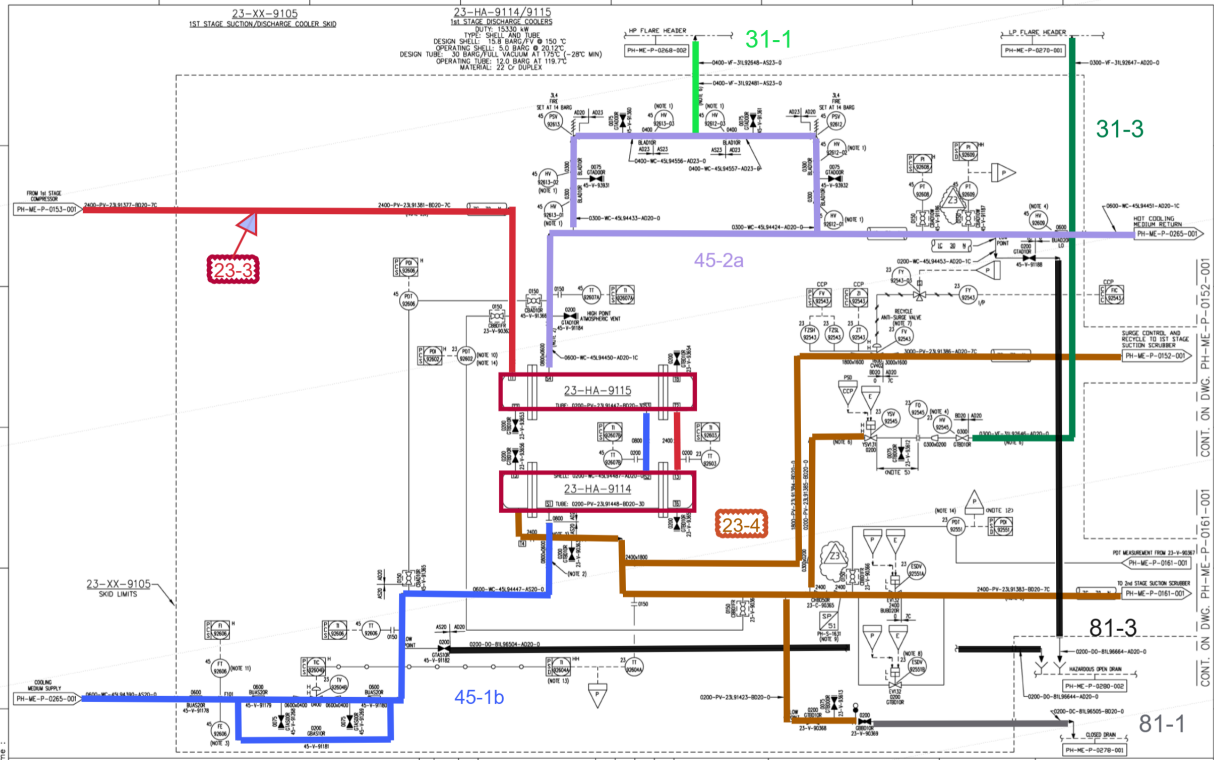

23-XX-9105
1ST STAGE SUCTION/DISCHARGE COOLER SKID
23-HA-9114/9115
1st STAGE DISCHARGE COOLERS
DUTY: 15,330 kW
TYPE: SHELL AND TUBE
DESIGN SHELL: 15.8 BARG/ATV @ 150 °C
OPERATING SHELL: 5.0 BARG @ 20/12°C
DESIGN TUBE: 30 BARG/FULL VACUUM AT 175°C (-28°C MIN)
OPERATING TUBE: 12.0 BARG AT 119.7°C
MATERIAL: 22 Cr DUPLEX
HP FLARE HEADER
PH-ME-P-0268-002
LP FLARE HEADER
PH-ME-P-0270-001
31-1
31-3
FROM 1st STAGE COMPRESSOR
PH-ME-P-0153-001
23-3
45-2a
HOT COOLING MEDIUM RETURN
PH-ME-P-0265-001
SURGE CONTROL AND RECYCLE TO 1ST STAGE SUCTION SCRUBBER
PH-ME-P-0152-001
CONT. ON DWG. PH-ME-P-0152-001
23-HA-9115
23-HA-9114
23-4
CONT. ON DWG. PH-ME-P-0161-001
PDT MEASUREMENT FROM 23-V-9080
PH-ME-P-0161-001
TO 2nd STAGE SUCTION SCRUBBER
PH-ME-P-0161-001
23-XX-9105
SKID LIMITS
81-3
HAZARDOUS OPEN DRAIN
PH-ME-P-0280-002
81-1
CLOSED DRAIN
PH-ME-P-0278-001
COOLING MEDIUM SUPPLY
PH-ME-P-0265-001
45-1b
NOTES:
1. KEY INTERLOCKED VALVE.
2. REMOVABLE MAINTANCE SPOOL.
3. CONDITIONING PLATE, PROVIDE STRAIGHT RUN OF 2D UPSTREAM AND 2D DOWNSTREAM.
4. KEY LOCKED VALVE.
5. MINIMUM 1 METER SEPARATION.
6. TO NOT PICKET.
7. LOCATE ANTI-SURGE VALVE AS CLOSE AS PRACTICAL.
8. 2" EQUALIZATION VALVE PARALLEL TO SHUTDOWN VALVE.
9. DISSIMILAR CHECK VALVES.
10. TRANSMITTER TO BE MOUNTED OFF SKID ON WEATHER DECK DUE TO THE ELEVATION OF THE PST TAPS ON SKID.
11. SEE DETAIL F101 ON PAID PH-ME-P-0102-001.
12. PERMISSIVE TO OPEN LARGE ESDV VALVE ON LOW DIFFERENTIAL.
13. SIGNAL DIRECT TO PSD, REPEATED TO PCS SYSTEM.
14. INSTRUMENT LINES ARE HEAT TRACED.
Z3 07.04.16 AS BUILT, MW- 33788
Z2 28.01.15 AS BUILT, AFA V-4426
Z1 26.06.14 AS BUILT, MW-19805
2 24.06.13 AS BUILT
REV DATE BY DESCRIPTION CHK ENGR APPR CLIENT
Wood Group Engineering (North Sea) Ltd.
MUSTANG INTERNATIONAL, LP
HOUSTON, TEXAS
PROJECT NO. 10910
bp
REGISTRATION CODES
AREA SYSTEM TYPE
T33-02 23 XB
DRAWING NO.
FACILITY CODE ORIG DISP SEQ. No. SHEET
PH ME P 0160 001
SCALE NONE
REV. Z3
VALHALL
RE-DEVELOPMENT PROJECT
PIPING & INSTRUMENT DIAGRAM
1st STAGE DISCHARGE COOLER
Field for file specification:
Field for date and time :